

Dutchess County Classic Half Marathon 2022

Poughkeepsie, NY




USATF Certificate

NY22008JG

Effective: 07/05/2022

Through: 12/31/2032

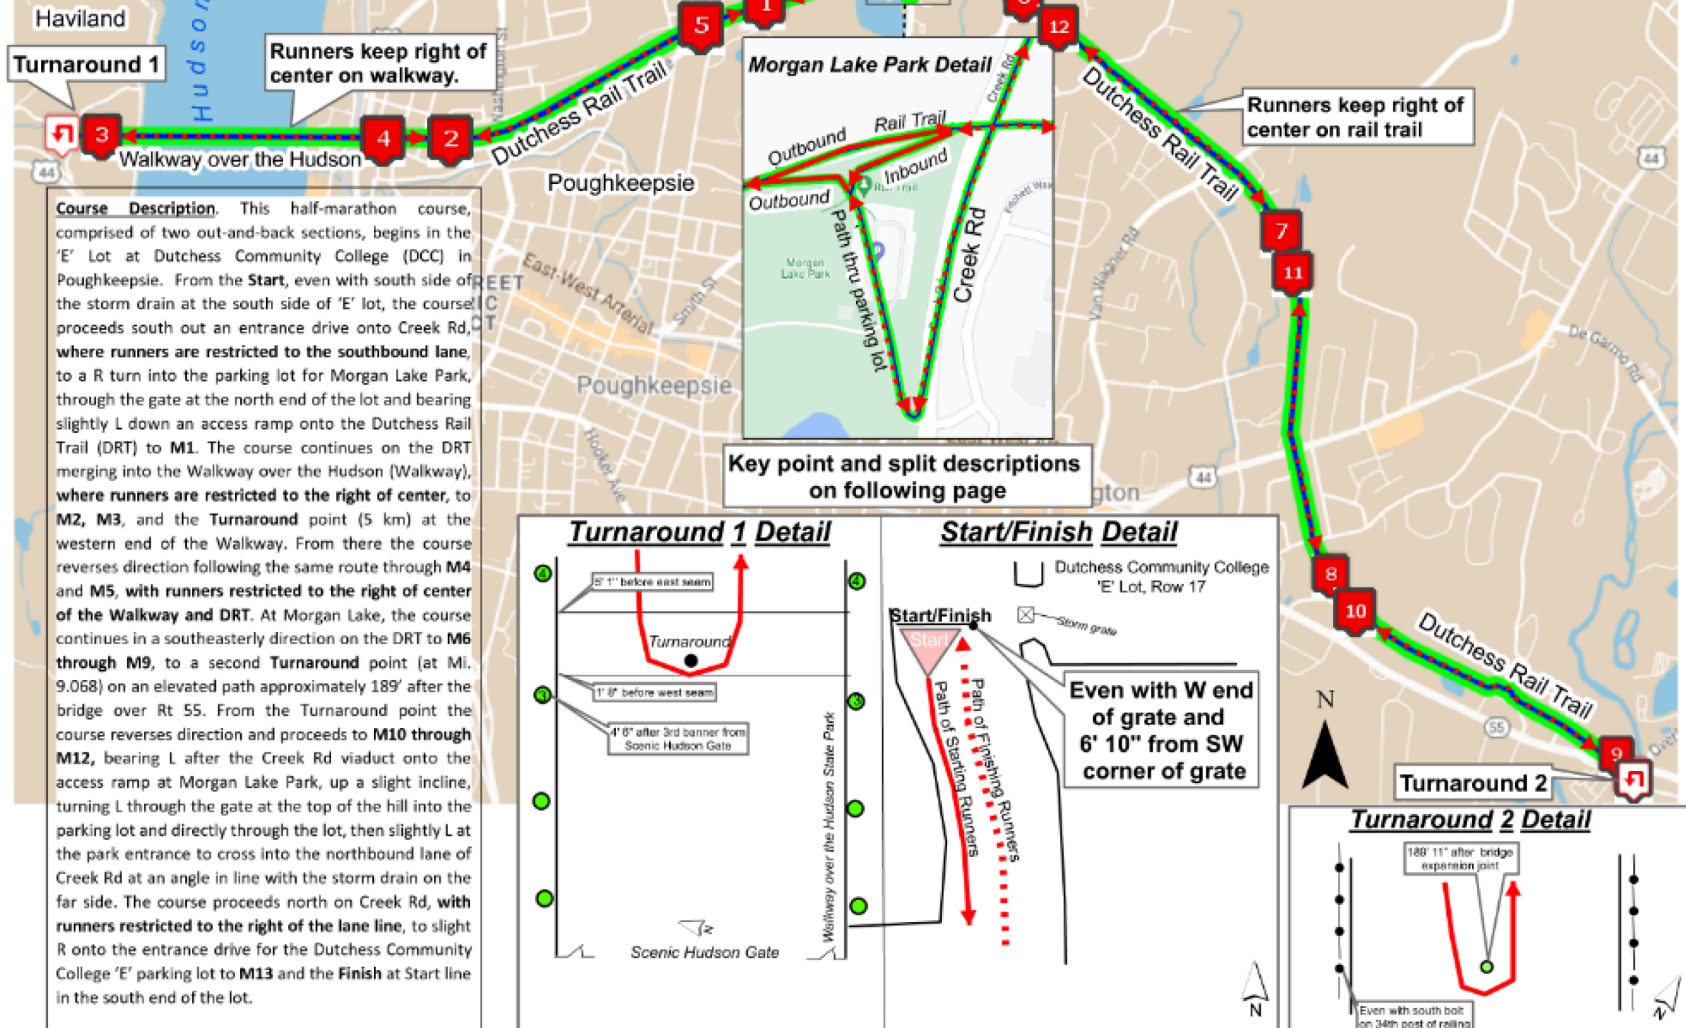


Measured 6/21 & 27/22 by Jim Gilmer | WA-A | jim.gilmer@gmail.com | 518-852-3562

Key Points: Dutchess County Classic Half-Marathon		
Point	Coordinates	Description
Start/Finish	41.723149°, -73.903049°	At south end of Dutchess Community College "E" Lot. Line is even with storm grate at west end of Row E17, 6' 10" from SE corner of grate. Marked with nail and "S/F" in white paint.
Mile 1	41.716072°, -73.914740°	On Dutchess Rail Trail (DRT) before Parker Ave overpass tunnel. Point is 11' 3" before E/edge of storm grate on L. Marked with nail and yellow paint.
Mile 2	41.710545°, -73.932320°	On Walkway Over the Hudson (Walkway), west bound. Point is 6 slab seams plus 1' 0" after electric junction box on L. Marked on R with yellow tape on railing and small yellow paint dot.
Mile 3	41.710673°, -73.951697°	On Walkway, west bound. Point is 7 slab seams plus 2' 8" after electric junction box on L and 1' before end post of tall black wire mesh safety fence. Marked on R with yellow tape on railing
Turnaround #1/ 5 km	41.710665°, -73.953705°	On Walkway, 130' 6" east of Scenic Hudson Gate. Point is in middle of walkway, 4' 6" after 3 rd banner; 1' 8½" after west joint and 5' 1" before east joint of first full slab. Marked on railings with yellow and blue tape, plus small yellow paint dot in middle of Walkway for placement of turnaround cone.)
Mile 4	41.710563°, -73.936447°	On Walkway, east bound, at 14 th post plus 1' 2" before end of tall black wire mesh safety fence on R and 25' before nearest electric junction box. Marked with yellow tape on railing.
Mile 5	41.715113°, -73.918626°	On DRT, west bound, before Buckingham Ave xing between posts 7 & 8 in post & rail fence on right. Point is 7' 11" after post 7 and 2' 1" before post 8. Marked on R with nail and yellow paint.
Mile 6	41.716251°, -73.900546°	On DRT after bridge over Rt 115. Point is between post 5 & 6 from end of fence on right. Marked with nail and green paint.
Mile 7	41.706679°, -73.886212°	On DRT, approx. 1,280' (.24 mi) after bridge over Rt 38 (Van Wagner Rd). No other reference available. Marked with nail and green paint.
Mile 8	41.692532°, -73.883573°	On DRT approx. 350' after Overocker Rd trail parking area. No other reference available. Marked with nail and green paint.
Mile 9	41.684843°, -73.867730°	On DRT, on bridge over Rt 55. Point is 31' 6" after expansion joint. Marked with green paint only.
Turnaround #2/ 9.068 mi.	41.684175°, -73.866865°	On DRT elevated concrete trail, 189' 11" after south expansion joint for bridge over Rt 55. Point is even with southern-most plate bolt at 34th railing post after bridge. Marked in green paint with dot inscribed in a circle in the center of the trail along with green tape on railings on either side
Mile 10	41.691071°, -73.882231°	On DRT, 47' 6" before "Demarco" bench on R. Marked with nail and green paint.
Mile 11	41.704944°, -73.885425°	On DRT, 10' 8" before "Warning-Steep Slopes" sign on R. Marked with nail and green paint.
Mile 12	41.715117°, -73.898688°	On DRT, 73' before "Building the Rail Trail" sign on L. Marked with nail and green paint.
Mile 13	41.721690°, -73.903539°	At entrance to DCC 'E' lot off northbound lane of Creek Rd. Point is 50' 6" before "One Way" sign on lot entrance drive. Marked with nail and green paint.
Note: Described as course is run. Splits are not certified and marked as described above.		

Dutchess County Classic 10K 2022


Dutchess Community College, Poughkeepsie, NY

Course Description. This out-and-back 10K course begins in the 'E' Lot at Dutchess Community College (DCC) in Poughkeepsie. From the Start, even with south side of the storm drain at the south side of 'E' lot, the course proceeds south out an entrance drive onto Creek Rd, **where runners are restricted to the southbound lane**, to a R turn into the parking lot for Morgan Lake Park, through the gate at the north end of the lot, and bearing slightly L down the access ramp onto the Dutchess Rail Trail (DRT) to **M1**. The course continues on the DRT merging into the Walkway over the Hudson (Walkway), **where runners are restricted to the right of center**, to **M2, M3** and the **Turnaround** point (5 km) at the western end of the Walkway. From there the course reverses direction following the same route through **M4, M5**, with **runners restricted to the right of center of the Walkway and the DRT**. At Morgan Lake Park, the course bears right onto an access path, up a slight incline, through the gate at the top, proceeding directly through the lot, bearing left at the park entrance to cross into the northbound lane of Creek Rd at an angle in line with the storm drain on the far side. The course proceeds north on Creek Rd, **with runners restricted to the right of the lane line**, to **M6**, and slight R onto the entrance drive for the Dutchess Community College 'E' parking lot to the **Finish** at Start line in the south end of the lot.

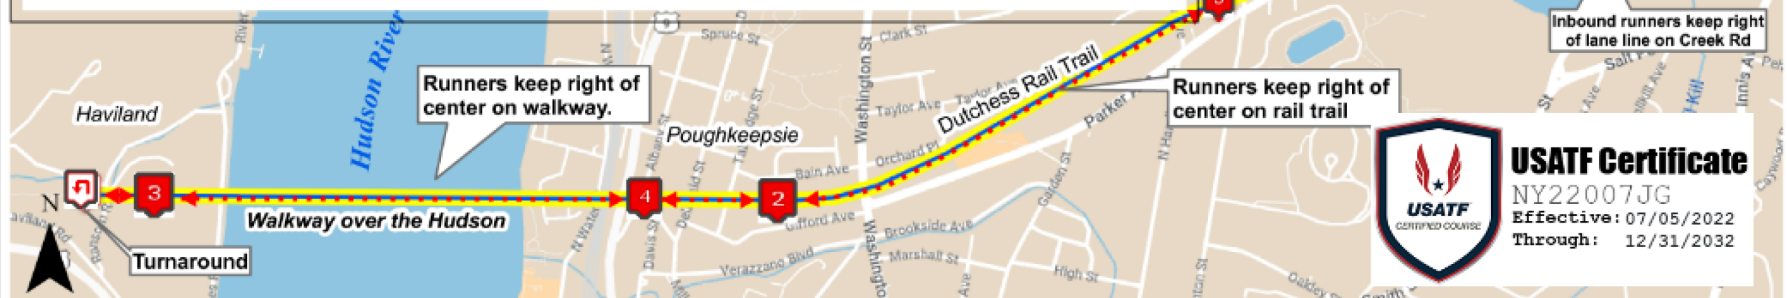

Key Points: Dutchess County Classic 10K		
Point	Coordinates	Description
Start/Finish	41.723149°, -73.903049°	At south end of Dutchess Community College "E" Lot. Line is even with storm grate at west end of Row E17, 6' 10" from SE corner of grate. Marked with nail and "S/F" in white paint.
Mile 1	41.716072°, -73.914740°	On Dutchess Rail Trail (DRT) before Parker Ave overpass tunnel. Point is 11' 3" before E/edge of storm grate on L. Marked with nail and yellow paint.
Mile 2	41.710545°, -73.932320°	On Walkway Over the Hudson (Walkway), west bound. Point is 6 slab seams plus 1' 0" after electric junction box on L. Marked on R with yellow tape on railing and small yellow paint dot.
Mile 3	41.710673°, -73.951697°	On Walkway, west bound. Point is 7 slab seams plus 2' 8" after electric junction box on L and 1' before end post of tall black wire mesh safety fence. Marked on R with yellow tape on railing.
Turnaround/ 5 km	41.710665°, -73.953705°	On Walkway, 130' 6" east of Scenic Hudson Gate. Point is in middle of walkway, 4' 6" after 3rd banner; 1' 8 1/2" after west seam and 5' 1" before east seam of first full slab. Marked on railings with yellow and blue tape, plus small yellow paint dot in middle of Walkway for placement of turnaround cone.)
Mile 4	41.710563°, -73.936447°	On Walkway, east bound, at 14th post plus 1' 2" before east end of tall black wire mesh safety fence on R and 25' before nearest electric junction box. Marked with yellow tape on railing.
Mile 5	41.715113°, -73.918626°	On DRT, west bound, before Buckingham Ave xing between posts 7 & 8 in post-and-rail fence on right. Point is 7' 11" after post 7 and 2' 1" before post 8. Marked on R with nail and yellow paint.
Mile 6	41.720333°, -73.904367°	On Creek Rd across from Stewarts. Point is 15' 5" after storm grate and 25' 3" before red hydrant. Marked on R with nail and yellow paint.


Note: Described as course is run. Splits are not certified and marked as described above.

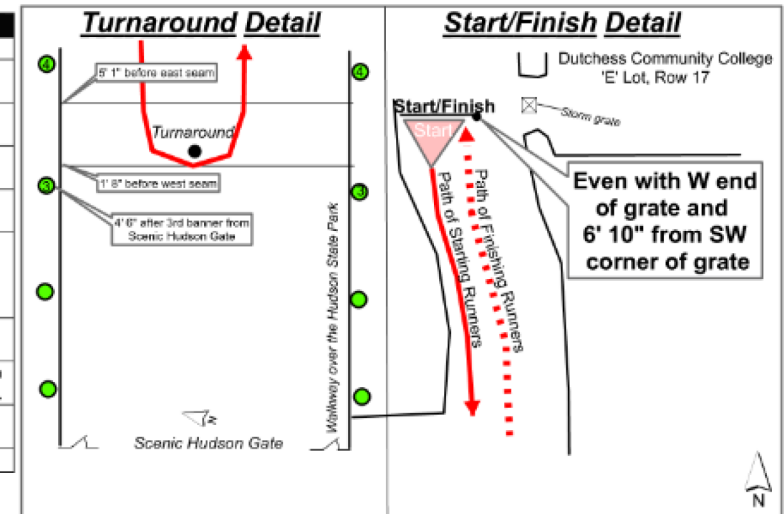

Measured 6/1 & 6/21/2022 and mapped by Jim Gilmer | WA-A | jim.gilmer@gmail.com | 518-852-3562

Dutchess County Classic 5K 2022

Start: Haviland, NY | Finish: Poughkeepsie, NY

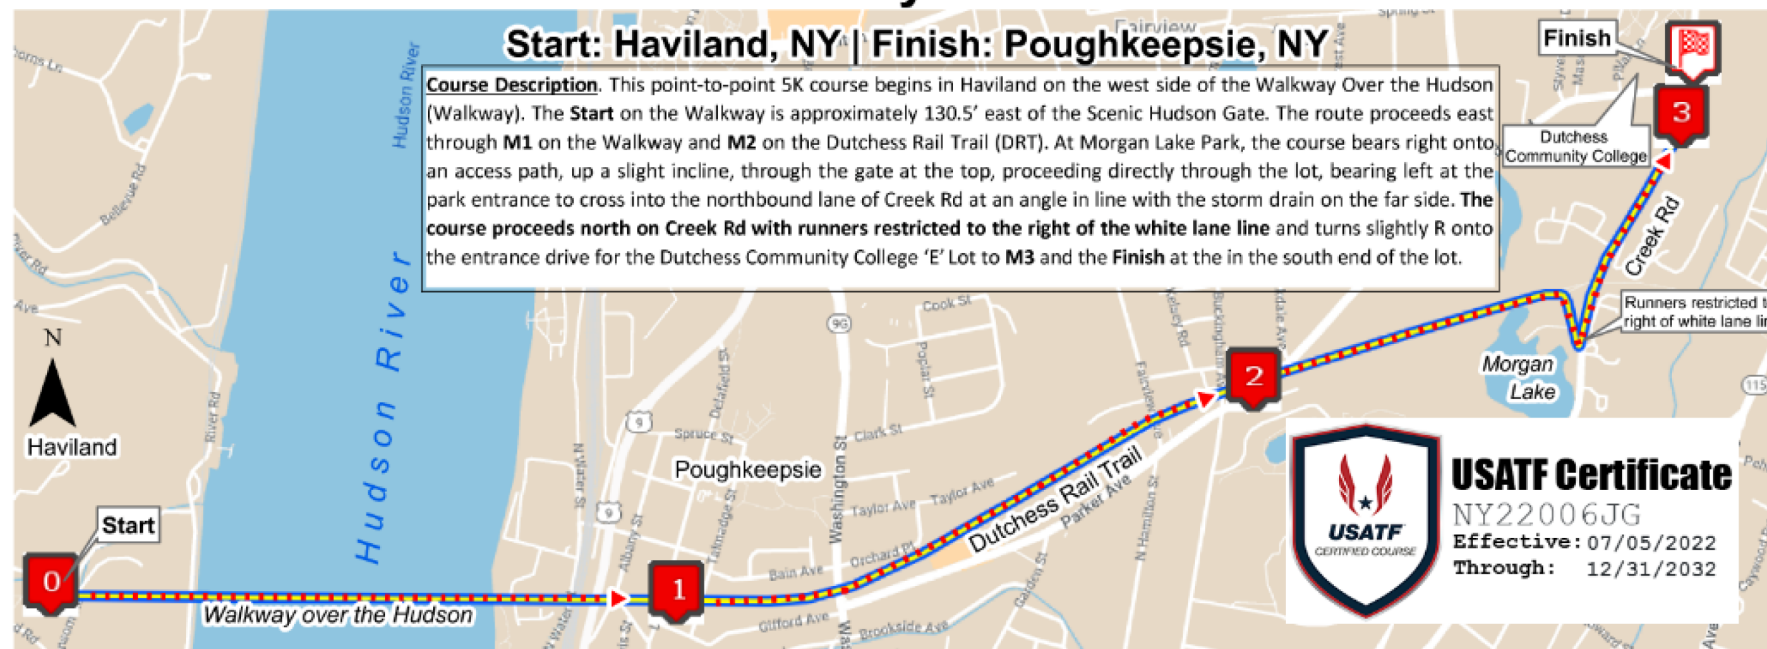


Key Points: Dutchess County Classic 5K

Point	Coordinates	Description
Start	41.710665°, -73.953705°	On Walkway over the Hudson (Walkway), 130' 6" east of Scenic Hudson Gate. Line is 4' 6" after 3 rd banner from Gate; 1' 8½" after west seam and 5' 1" before east seam of first full slab. Marked on railings on either side with yellow and blue tape. (Middle of line is turnaround point for 10K and Half-Marathon courses. Marked with small yellow paint dot.)
Mile 1	41.710527°, -73.934397°	On Walkway, east bound. Point is 21' 5" before seam for slab with "400 Years of History" sign for rowing on right. Marked with blue tape on railing.
Mile 2	41.715672°, -73.916620°	On Dutchess Rail Trail, east bound. Point is 11' 6" after "HJ 12.5" sign on left and 20' before storm grate at Parker Ave overpass tunnel on left. Marked with nail and blue paint on R.
Mile 3	41.721718°, -73.903535°	On one-way entrance drive to DCC 'E' Lot off northbound lane of Creek Rd. Point is 36' 11" before "One Way" sign on lot entrance drive. Marked with nail and blue paint on R.
Finish	41.723149°, -73.903049°	At south end of Dutchess Community College (DCC) 'E' Lot. Line is even with storm grate at west end of Row E17, 6' 10" from SE corner of grate. Marked with nail and "S/F" in white paint.

Note: Described as course is run. Splits are not certified and marked as described above.

Start Detail

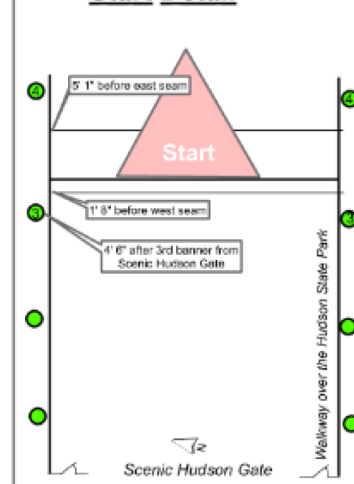

Finish Detail

